

DIAGRAM FROM ACTUAL SURVEY


COUNTY OF DORSET

PARISH OF KAY

Scale 5 chains to an inch.

REFERENCE TO CORNERS.

CORNER	BEARING	DISTANCE IN LINKS	FROM

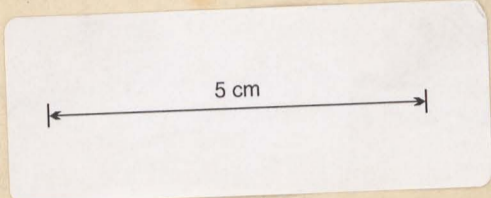

15heads
10heads
Not granted, cancelled.
Lease 21.7.04

DUPLICATE.

Nº OF APPLICATION ~~265, 364, 474~~ ~~New Brothers Home No 1 Tin Mining Co. No Liability~~

93W
(2) Brises Tin Mines Ltd
Sheet No 1

Not to be dealt with at present awaiting...
17/10/00

99. 0. 0
W. H. Johnson
Pur:

91. 0. 30
R. R. Bignell
Pur:

Crown Land

RINGAROOMA RIVER
360° 15' 2 1/2" LRS
To C.P. from 3.

To be filled in by Surveyor

- Date of instructions Rec^d from Company
- Survey commenced 1.5.1900
- Survey finished 12.6.1900
- Error of close 1 in
- Plotted by
- Finally examined by
- Entered on General Plan by *W. 27.6.1900*

Maybe acted upon *26.7.1900*
Acted upon

Report
Cut/mt

SP
76/01

Donald Fraser
Auth^r & Surveyor



District Surveyor

Tracing to Linn
23-6-1900

