


P L A N
— O F —
W O R K I N G S

Scale 50 feet to 1 inch

Geological Plan of Rorand Hill Mine.

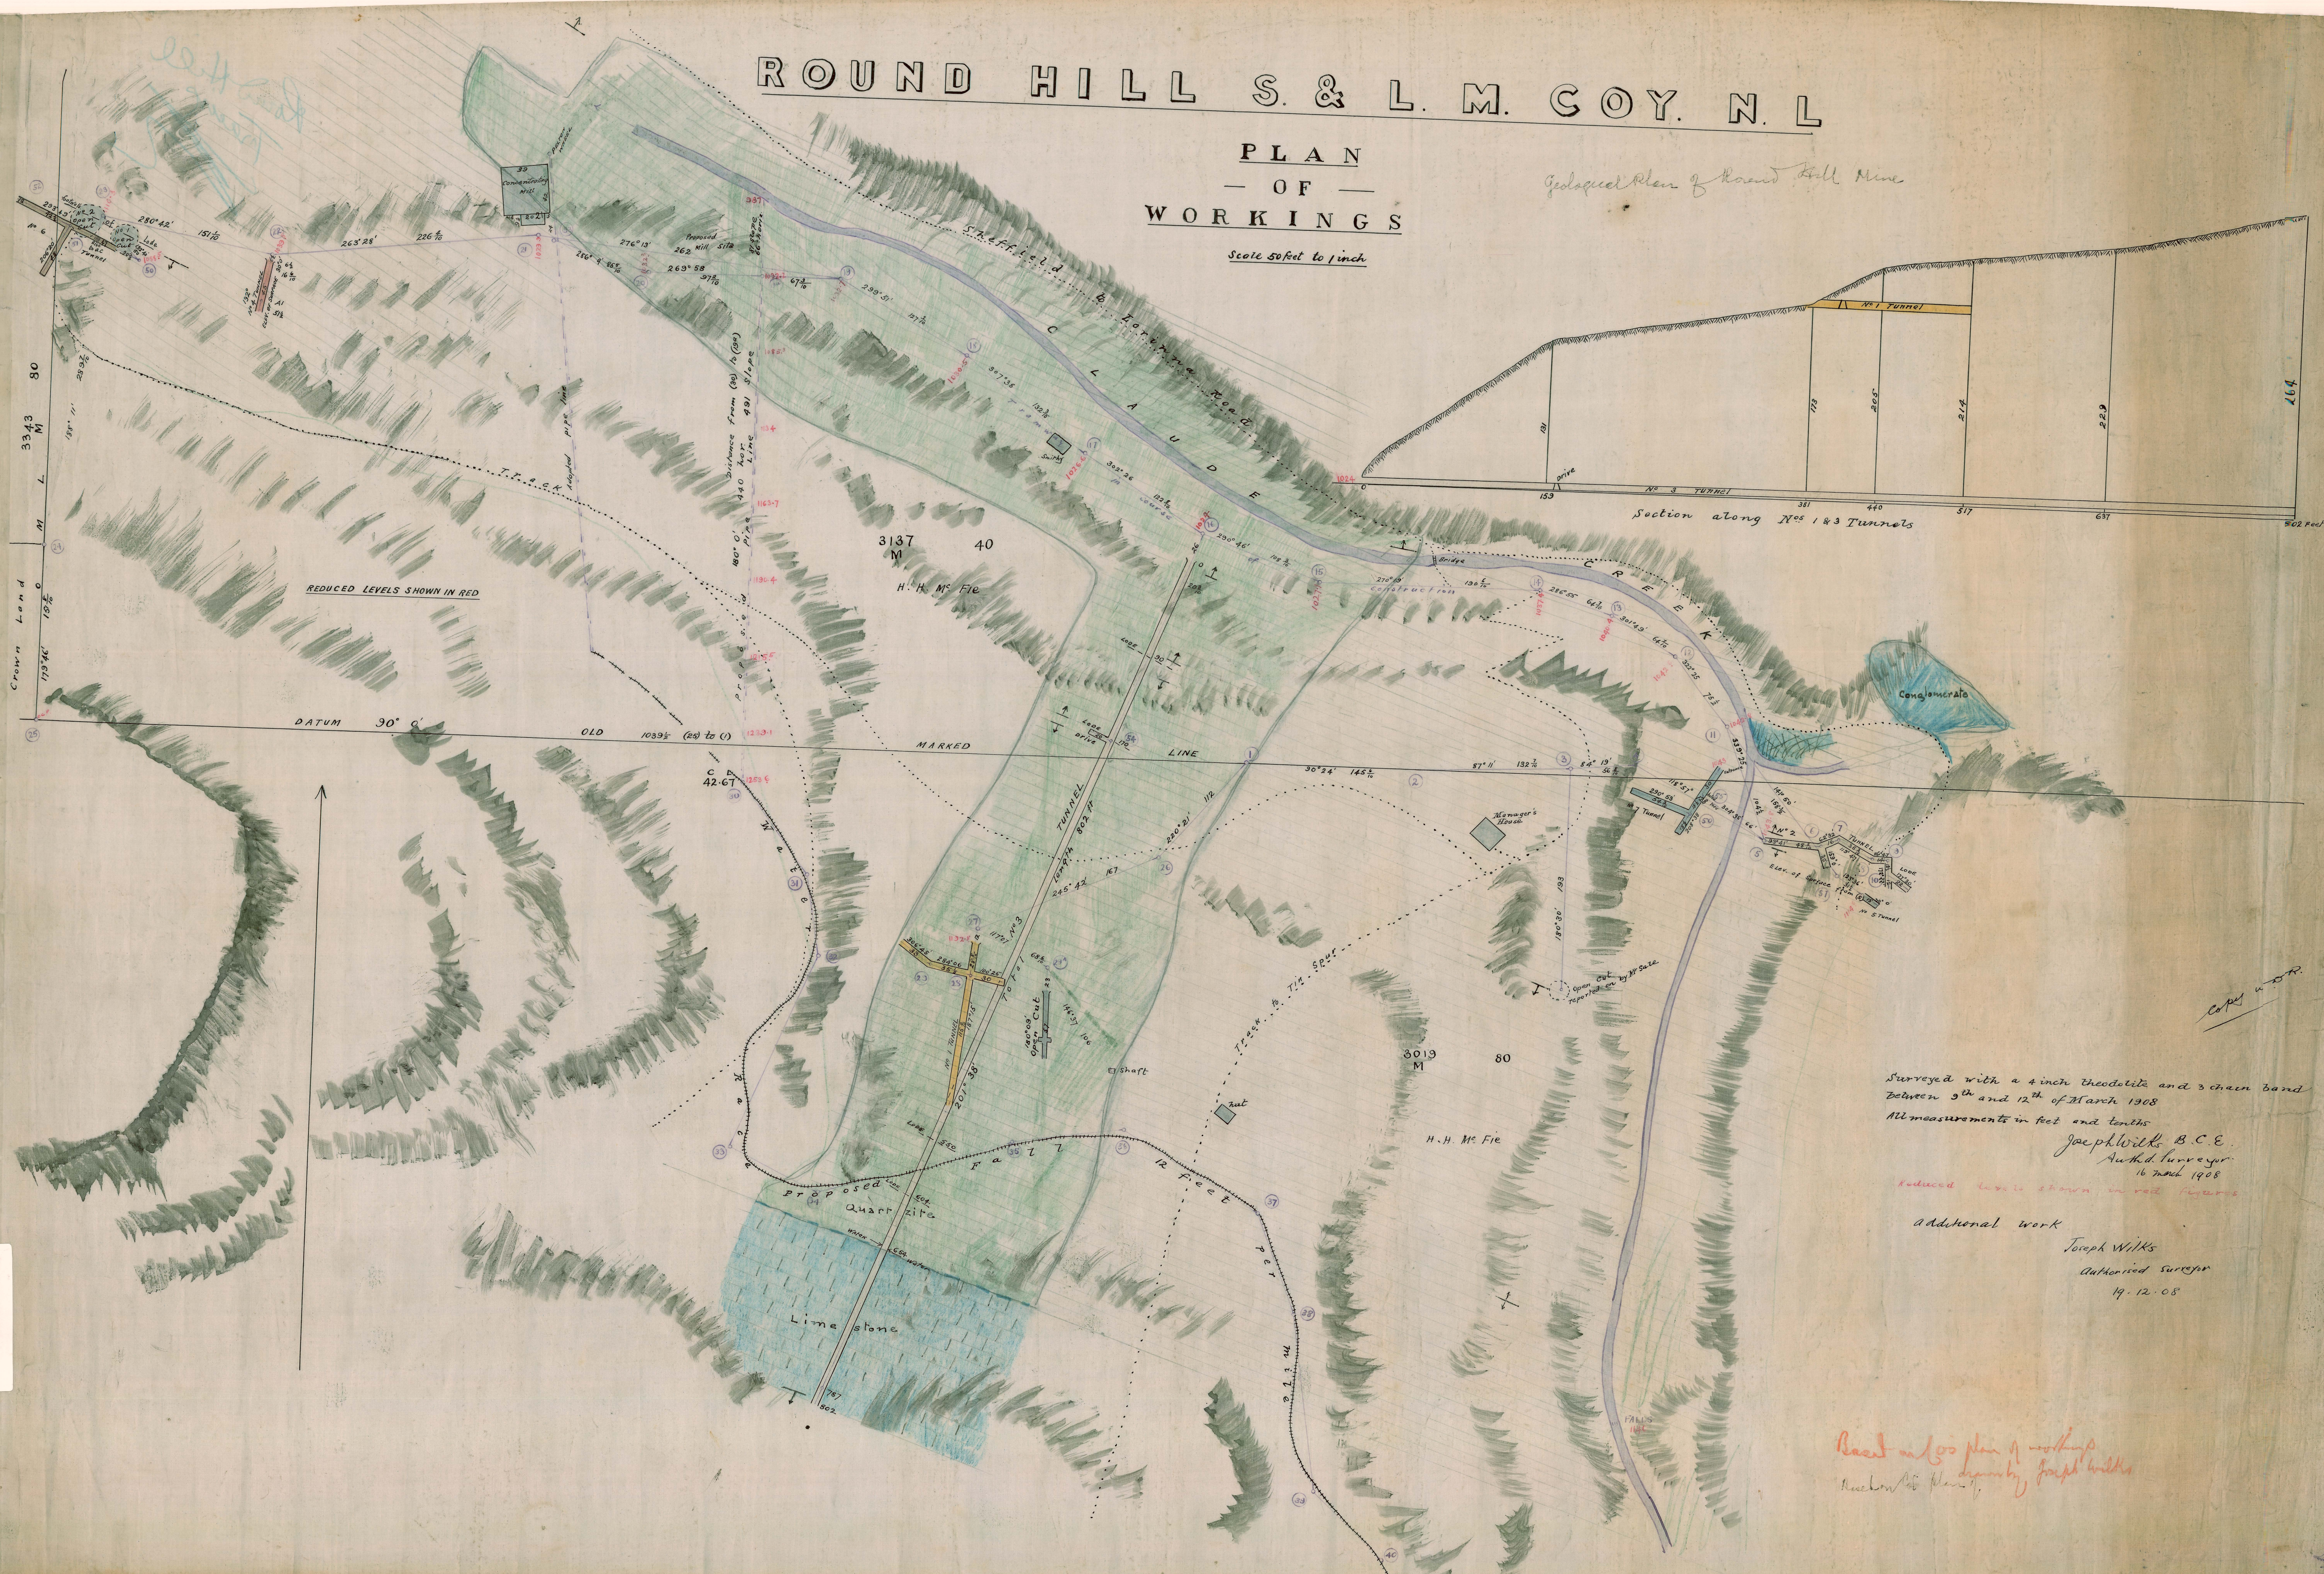

All measurements in feet and tenths

Joseph Wilks B.C.E.
Authd. Surveyor.
16 March 1908

16 March 1908

Reduced levels shown in red figures

additional work

Joseph Wilks

Authorised Surreyor

19. 12. 08

Based on his plan of workings
Anthon's plan of, drawn by Joseph Walker