


316-04

316-04

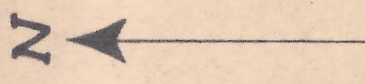

98

97

96

95

9700 N


9600 N

9500 N

3E

5200 E

3D

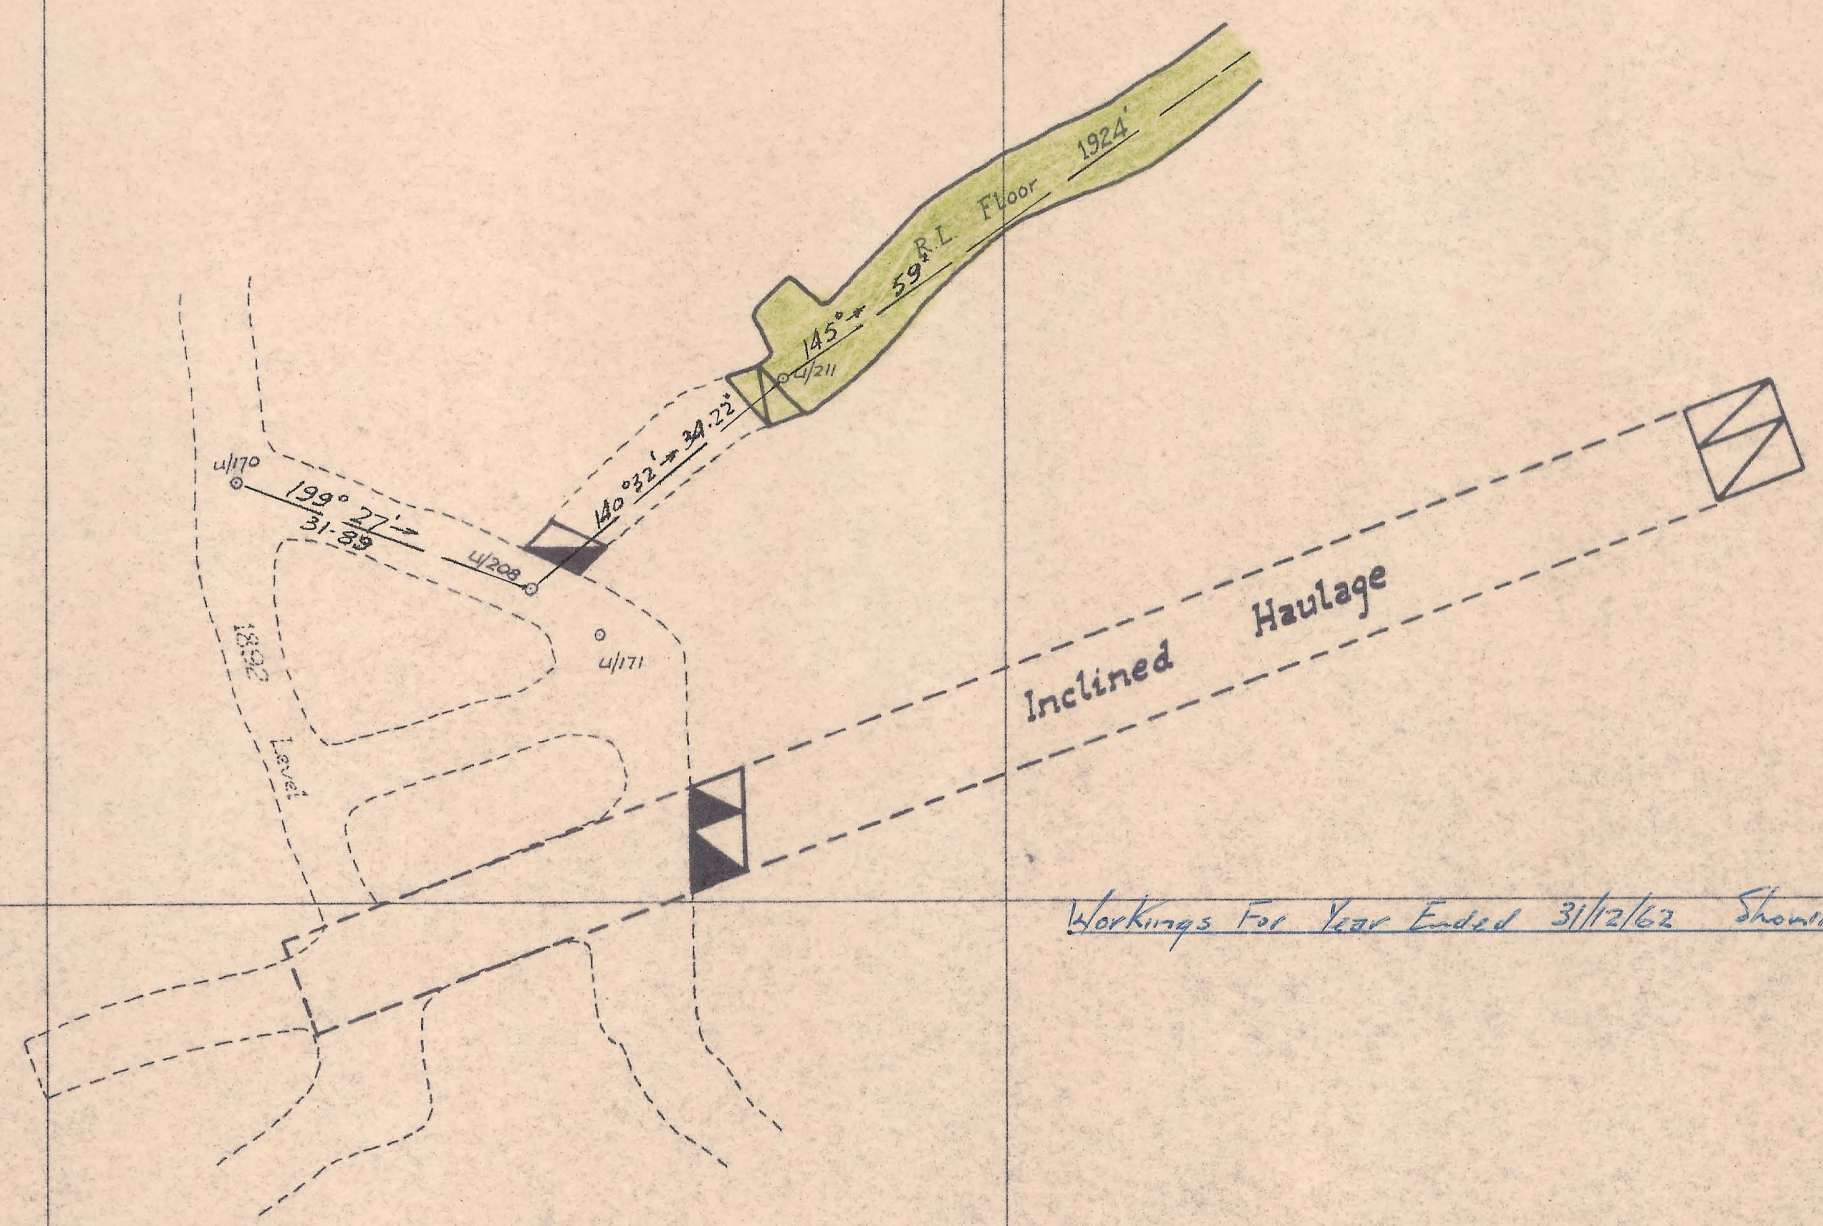


Inclined Haulage

Workings For Year Ended 31/12/62 Shown In Red.

Mine Manager	Mine Surveyor
<i>[Signature]</i>	<i>[Signature]</i>

5100 E

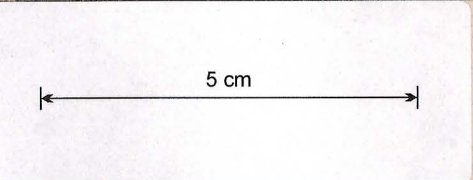

1924 Level - 3D/97 Sub Level

Scale :- 1" = 20'

Workings For Year Ended 31-12-61 Shown In Green.

Mine Man. :- *[Signature]*  
Surveyor :- *[Signature]*

R.A.T.M.

P. Townsend 18-1-62