


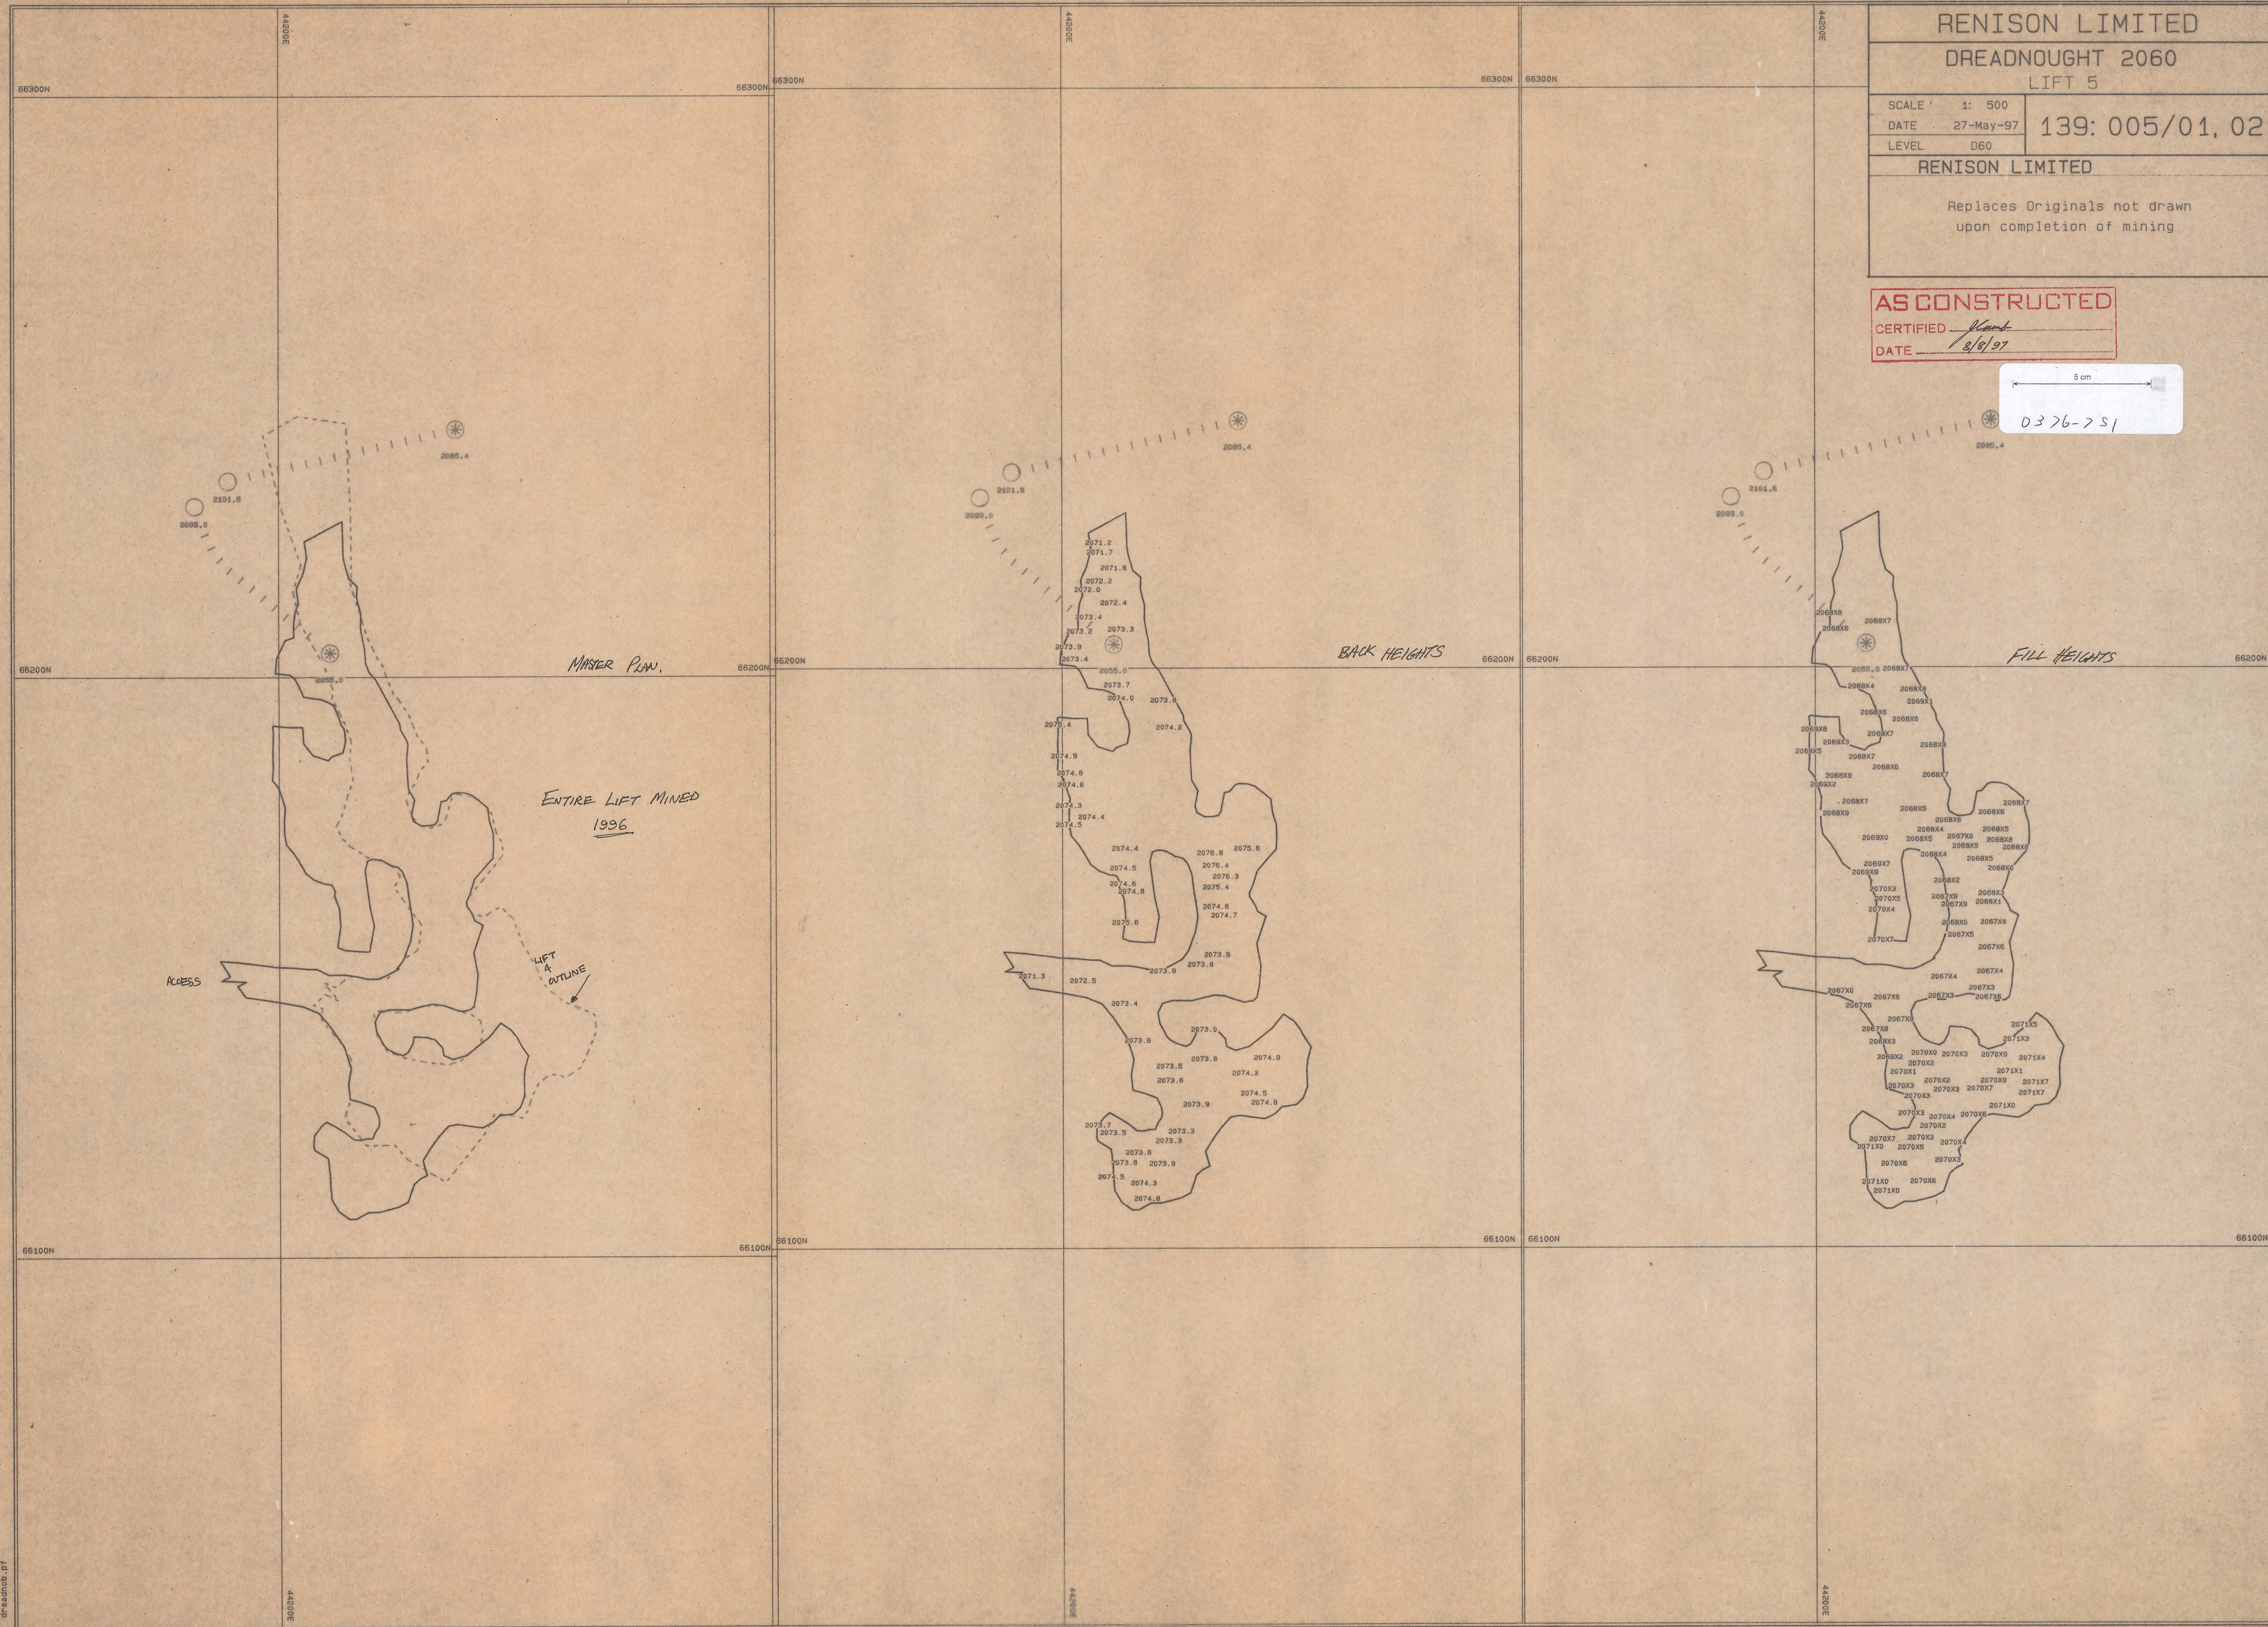

RENISON LIMITED	
DREADNOUGHT 2060	
LIFT 5	
SCALE 1: 500	139: 005/01, 02
DATE 27-May-97	
LEVEL D60	
RENISON LIMITED	
Replaces Originals not drawn upon completion of mining	

AS CONSTRUCTED
CERTIFIED *[Signature]*
DATE 2/8/97

5 cm
0.376-751

0.376-751