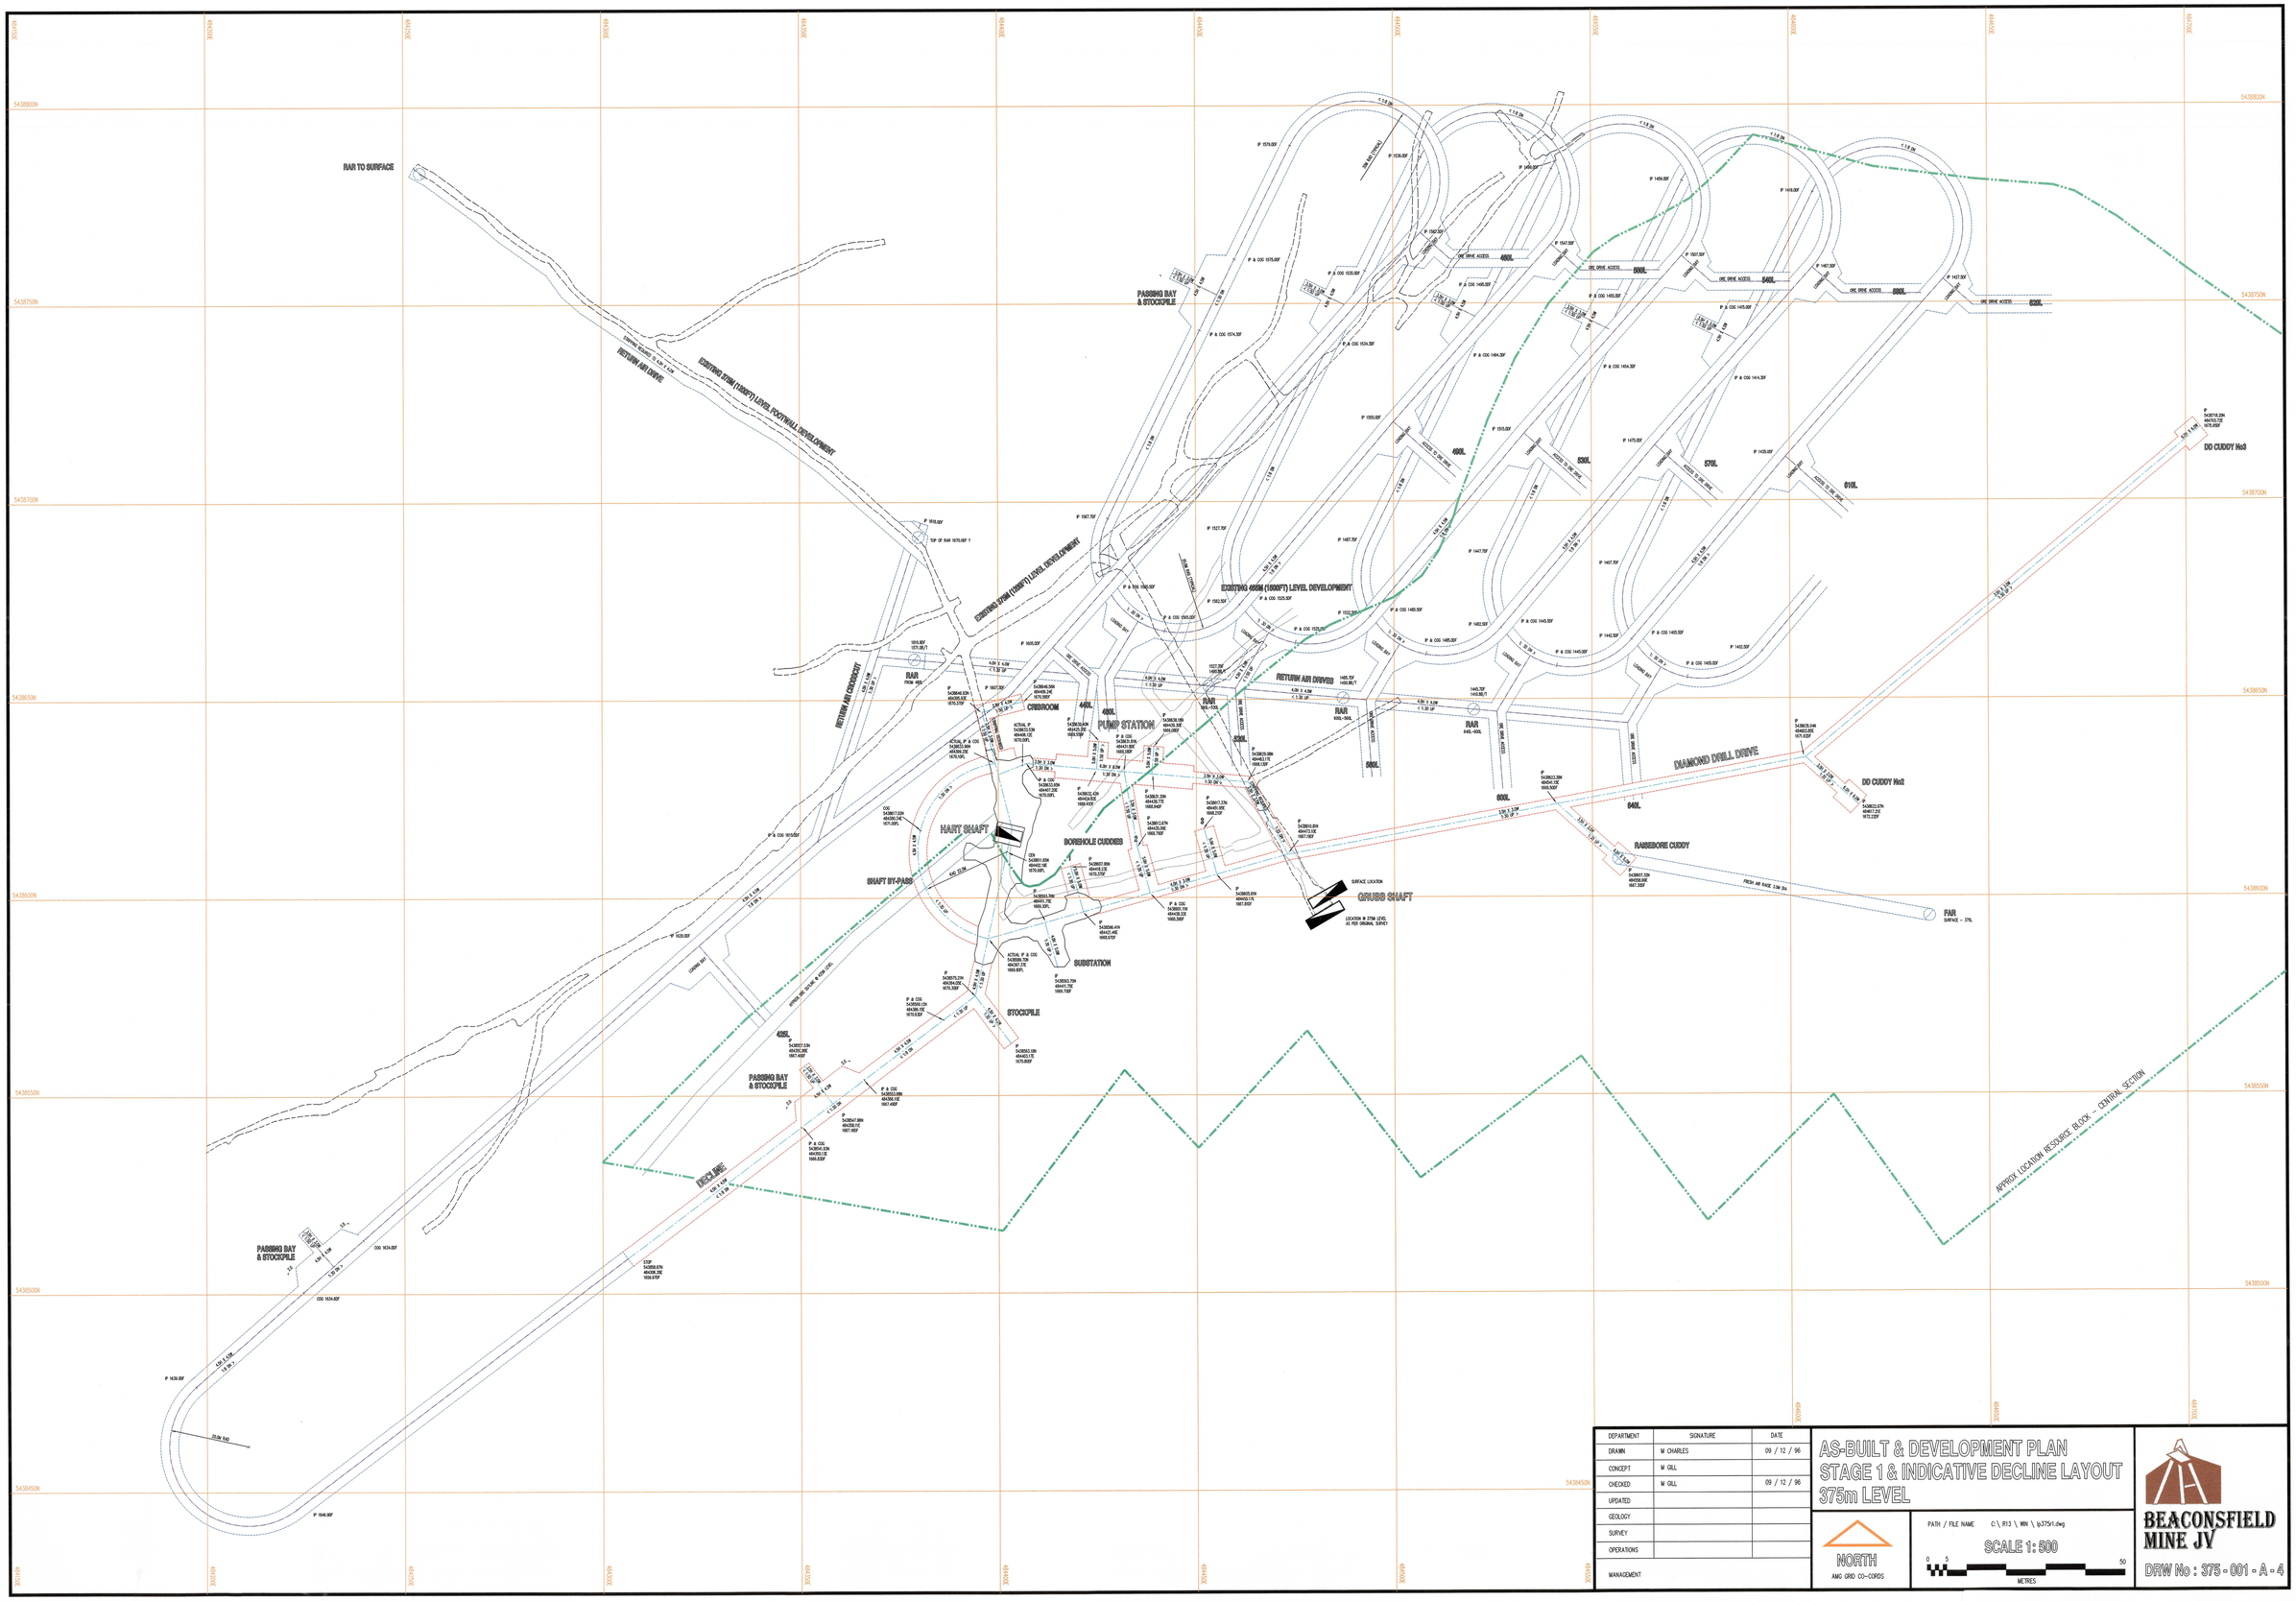AS-BUILT & DEVELOPMENT PLAN - 375M LEVEL - SCALE 1:500